


BLOCK A - FIRST FLOOR PLAN

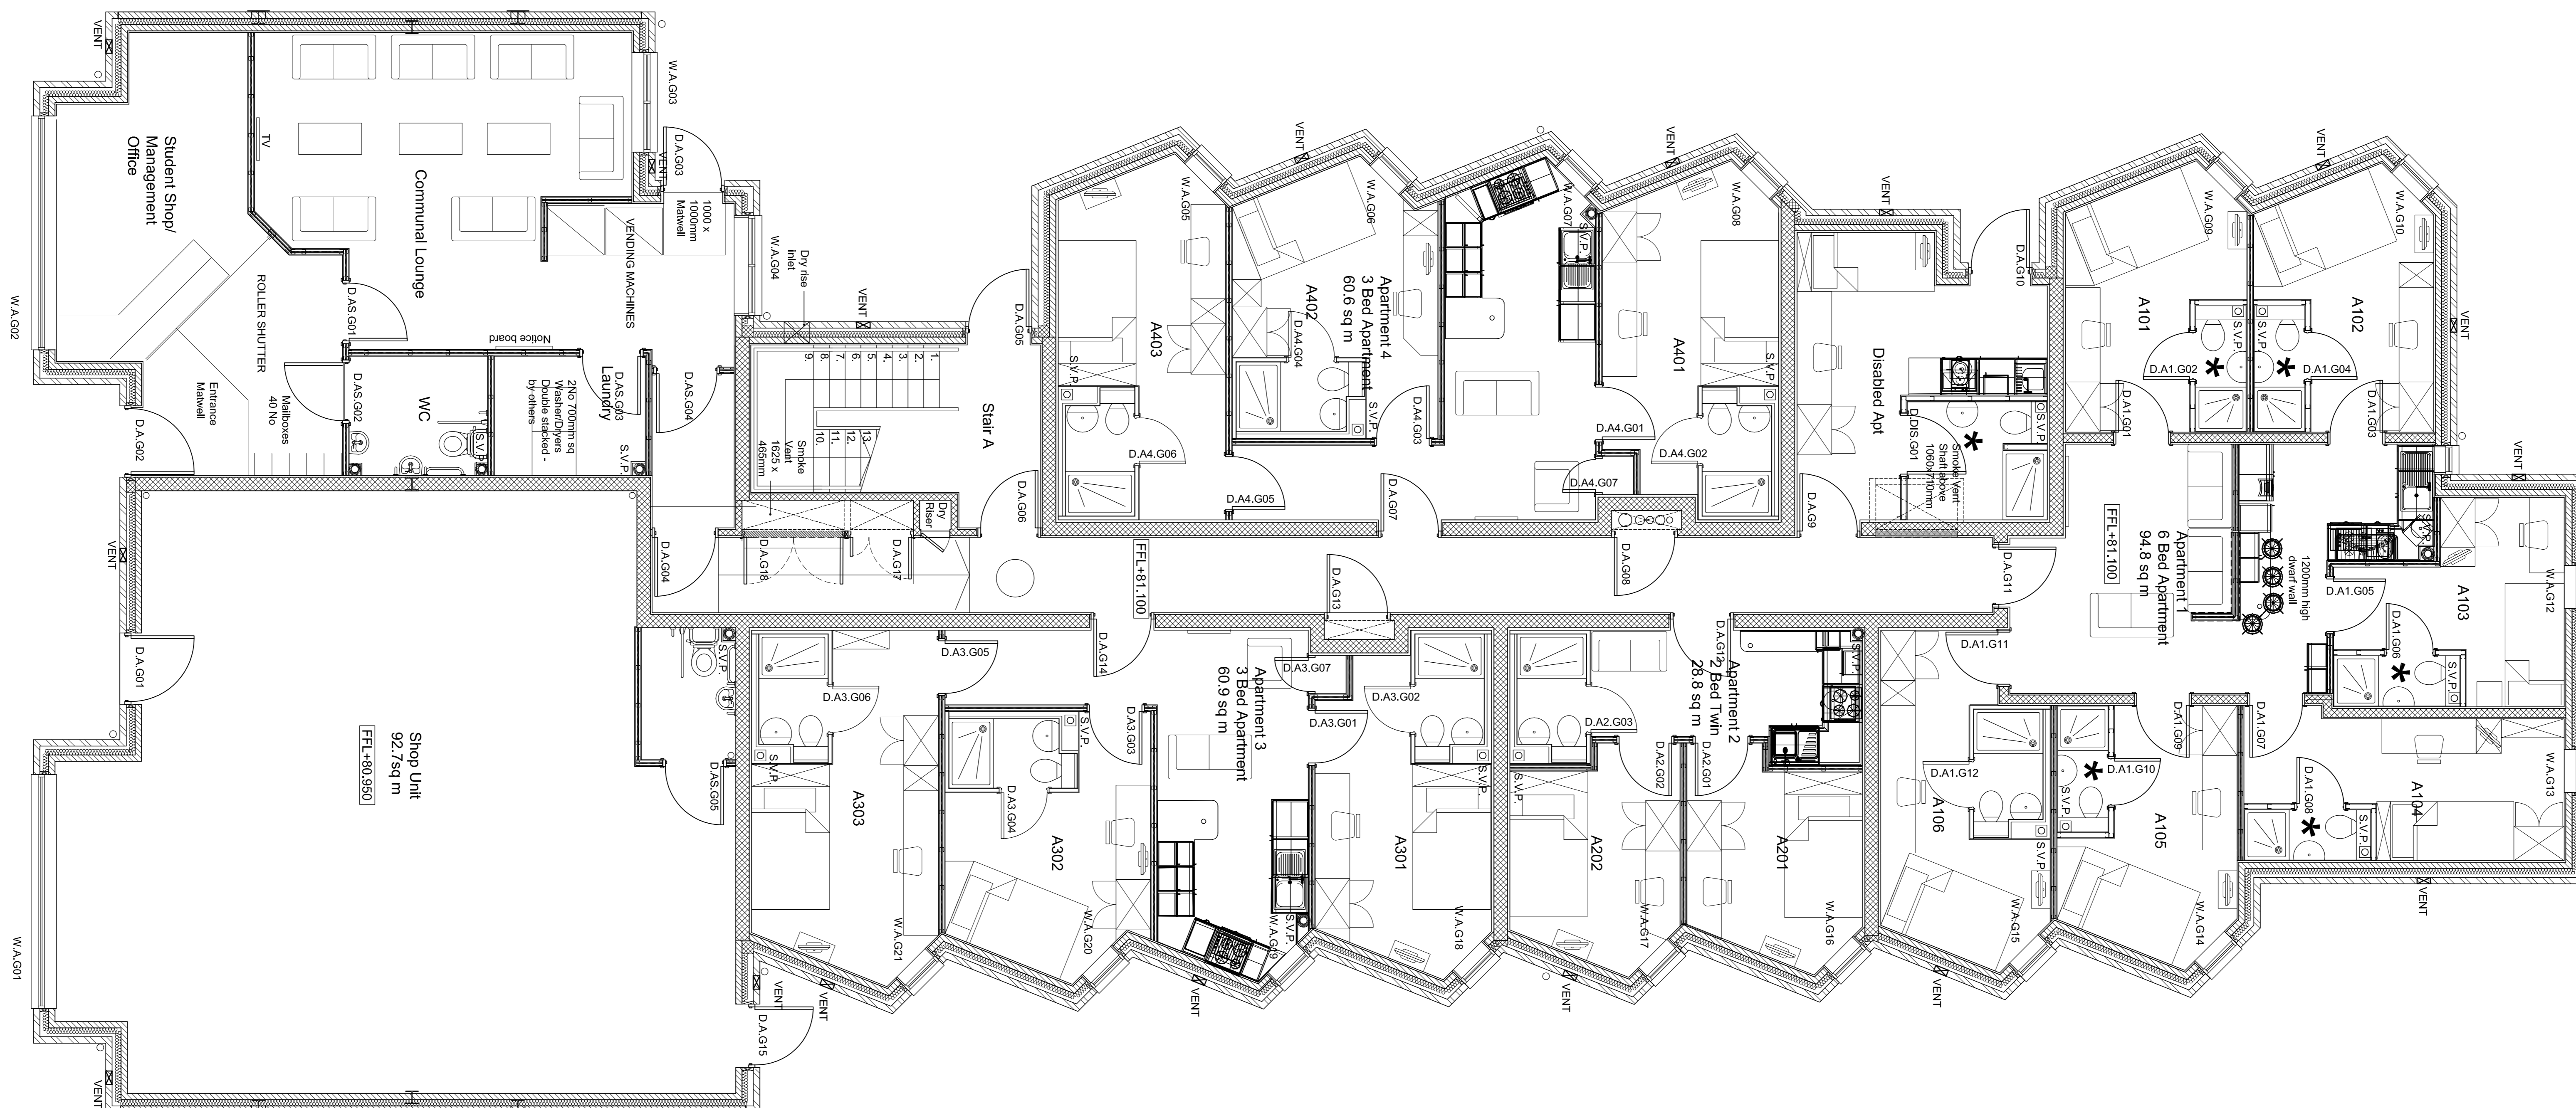

BLOCK A - GROUND FLOOR PLAN

RECORD DRAWING

The information shown on this drawing reflects details original, incorporated or revised by Corstorphine & Wright and only such other variations as have been advised to them by other parties.
 Corstorphine & Wright cannot guarantee that such details shown have been worked to.

H	02.07.13	Record drawing
G	18.04.13	Dividing stud wall added to apartment 8
F	13.02.13	D.G.17 & D.G.18 amended
E	30.11.12	Dry steel location added
D	27.11.12	Stairs amended & cleaners cupboard removed
C	15.11.12	General updates made
B	02.11.12	Smoke vents and risers updated.
A	20.09.12	Layouts updated.

REVISION DATE NOTES

RECORD DRAWING

Client

GB BUILDING SOLUTIONS

Project

46 THE COMMON
HATFIELD

Drawing Title

BLOCK A
GROUND AND FIRST FLOOR PLANS

Drawn	Checked	Project Date	Date
JNS	PH	A0 1:50	14.09.12
Project No.	Drawing No.	Revision	
11699	2007	H	