


BLOCK A - THIRD FLOOR PLAN

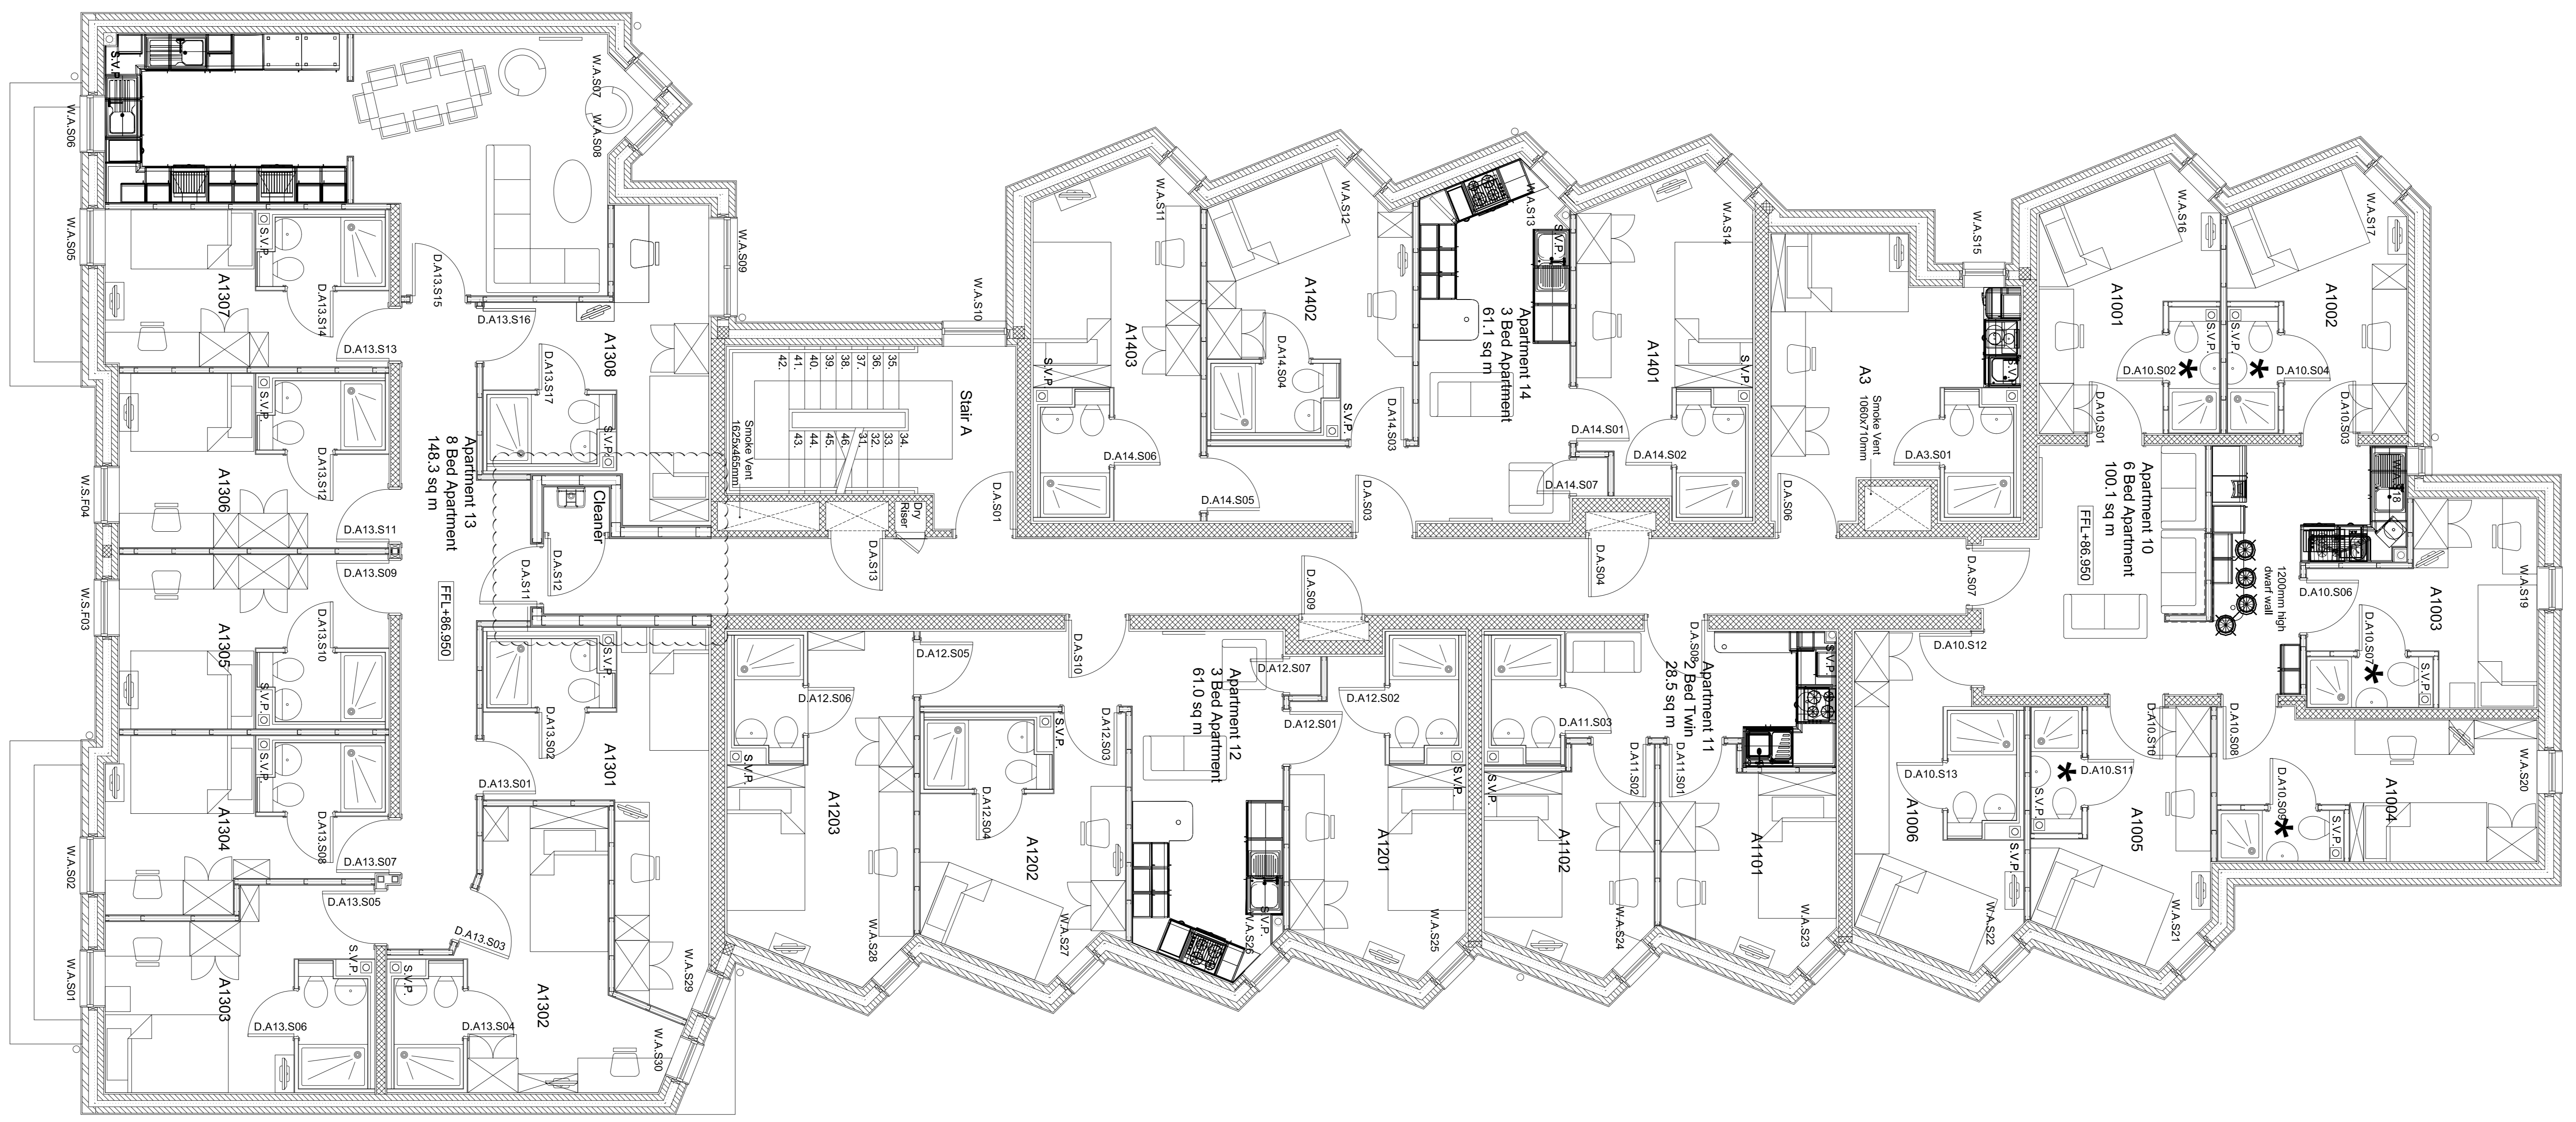

BLOCK A - SECOND FLOOR PLAN

RECORD DRAWING

The information shown on this drawing reflects details originally incorporated or agreed by Corstorphine & Wright and only such other variations as have been indicated to them by other parties. Corstorphine & Wright cannot guarantee that such details shown have been worked to.

H	02.07.13	Record drawing
G	18.04.13	Stud dividing wall added to apartment 13
F	08.05.13	Third floor roof design amended
E	04.12.12	Smoke vent also amended
D	30.11.12	Smoke vent added to stair well
C	15.11.12	General updates made
B	02.11.12	Smoke vents and risers updated.
A	20.09.12	Layouts updated.

REVISION DATE NOTES

RECORD DRAWING

Client: GB BUILDING SOLUTIONS

Project: 46 THE COMMON HATFIELD

Drawn	Checked	Panel Size	Scale	Date
JNS	PH	A0	1:50	14.09.12
Project No.	Drawing No.	Revision		
11699	2008	H		